
THE PHOENIX SURVEYING COMPANY, INC.

CONSULTANTS * SURVEYORS * PLANNERS 17840 TOLEDO BLADE BLVD., SUITE B, PORT CHARLOTTE, FL.,33948 FAX (941) 627 - 5168 PH. (941) 629 - 6801

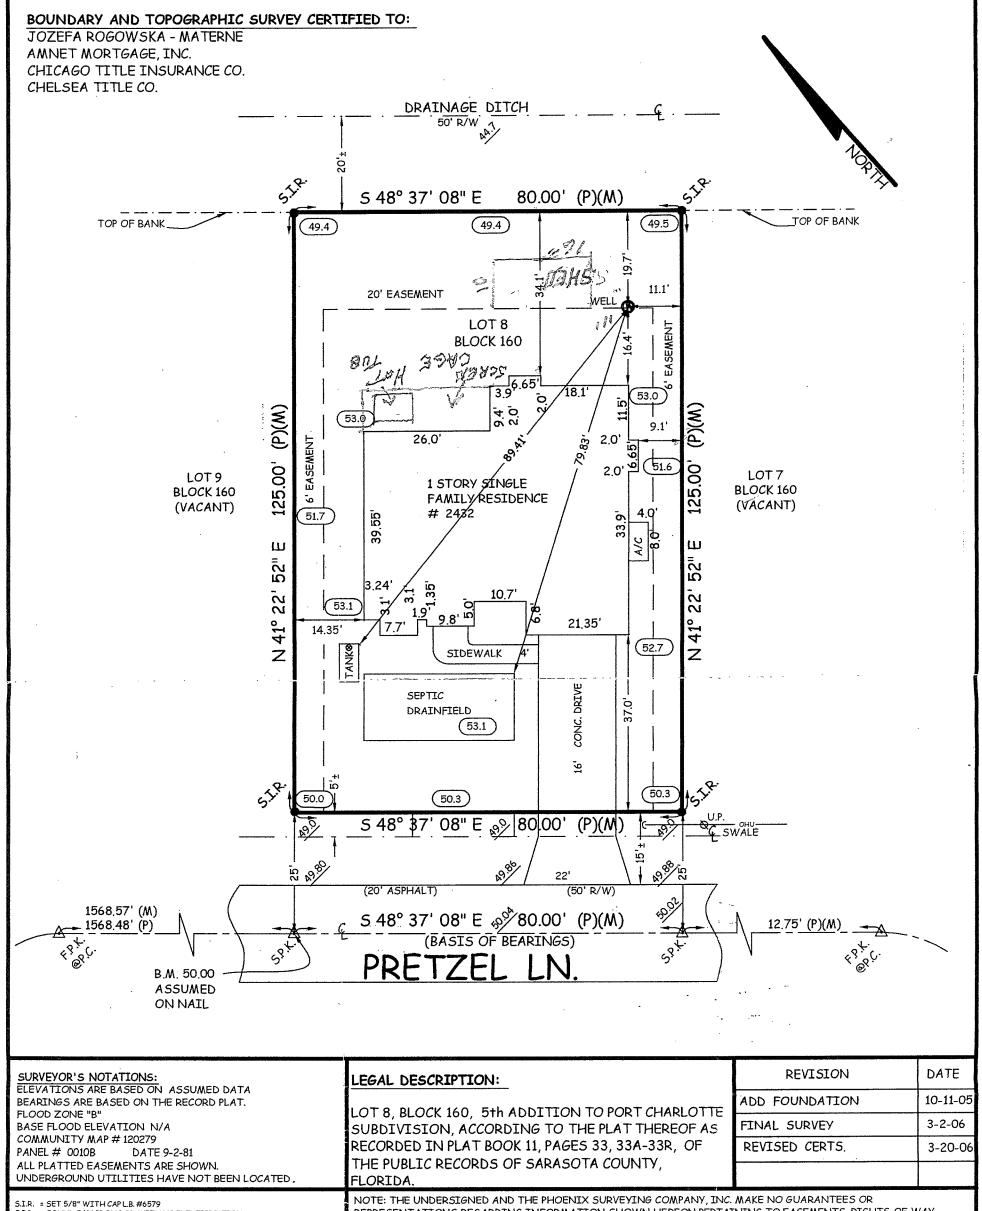

F.I.R. = FOUND 5/8" IRON ROD WITH NO IDENTIFICATION = IRON PIPE S.P.K. = SET P.K. NAIL F.P.K. = FOUND P.K. NAIL = PARKER KALON BRAND MASONRY NAIL = DRTLL HOLE P.C.P. = PERMANENT CONTROL POINT
P.R.M. = PERMANENT REFERENCE MONUMENT (53.1) = AS-BUILT TOPOGRAPHY

= CONCRETE MONUMENT = MEASURED DATA = RECORD PLAT DATA = CALCULATED DATA = DELTA = ARC LENGTH = RADIUS = CHORD LENGTH CHD

CH.B. = CHORD BEARING
B.M. = BENCH MARK
P.O.L. = POINT ON LINE R/W = RIGHT-OF-WAY

= CENTERLINE = POINT OF CURVATURE = FINISHED FLOOR ELEVATION = WATER METER

= FOUND F.N. = FOUND NATL F.N.D. = FOUND NAIL & DISK A.T.O.S. = AT TIME OF SURVEY E.O.W. = EDGE OF WATER T.O.B. = TOP OF BANK

O.H.U. = OVERHEAD UTILITY
U.P. = UTILITY POLE U.P. GUY = GUY WIRE = PHONE SERVICE BOX = MANHOLE = FIRE HYDRANT

L.P.

= CATCH BASIN = LAST DAY IN FIELD SCALE: 1" = 20' = LIGHT POLE

R.J. STRICKLAND, JR.,

FLORIDA REGISTRATION # 6144

REPRESENTATIONS REGARDING INFORMATION SHOWN HEREON PERTAINING TO EASEMENTS, RIGHTS-OF-WAY, SETBACK LINES, AGREEMENTS, RESERVATIONS, AND OTHER SIMILAR MATTERS. THE SURVEY AS SHOWN HEREON WAS MADE WITHOUT BENEFIT OF ABSTRACT OF TITLE. THIS SKETCH IS NOT VALID UNLESS IT BEARS AN ORIGINAL SIGNATURE AND AN EMBOSSED SURVEYORS SEAL. ANY ADDITIONS AND/OR DELETIONS TO THIS SKETCH ARE PROHIBITED WITHOUT THE WRITTEN CONSENT OF THE UNDERSIGNED.

I HEREBY CERTIFY THAT THIS SURVEY WAS MADE UNDER MY RESPONSIBLE CHARGE AND MEETS THE MINIMUM TECHNICAL STANDARDS AS SET FORTH BY THE FLORIDA BOARD OF PROFESSIONAL SURVEYORS AND MAPPERS IN CHAPTER 61617-6, FLODIDA ADMINISTRATIVE CODE, PURSUANT TO SECTION 472.027, FLORIDA STATUTES.

> 3-3-06 10-10-05* DATE 4-16-05* L.B. # 6579 P.S.M.

DRW. BY: FVW

F.B./PG. 216/68

JOB # 05-12545